





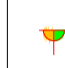
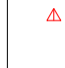







DO NOT SCALE FROM THIS DRAWING
 All dimensions to be verified on site any discrepancies are to be reported in Eatio Interiors before proceeding with work.
 All area dimensions are approximate and can only be verified by a detailed survey. Any decisions to be made on the basis of area information shown on this drawing should include allowances for increases and decreases inherent in the design and building process.

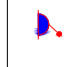NOTES:

Key

-  New Distribution Board
-  Floorbox with 2x DSSO & 2x data points (positioned in the nearest full tile from the perimeter wall)
-  Switched and unswitched spur at high level
-  Switched spur set @ 450ffl
-  Switched spur set mid height (to be confirmed on site)
-  DSSO set @ 450ffl
-  DSSO set above kitchen worksurface height to be confirmed on site
-  SSSO for cleaners @ 450mm ffl
-  Single data plate cat 6
-  4 no. Spare Data within ceiling void (for possible future office split)
-  Perimeter wall mounted Trunking
-  Wifi Point (Position Indicative to be confirmed on site)

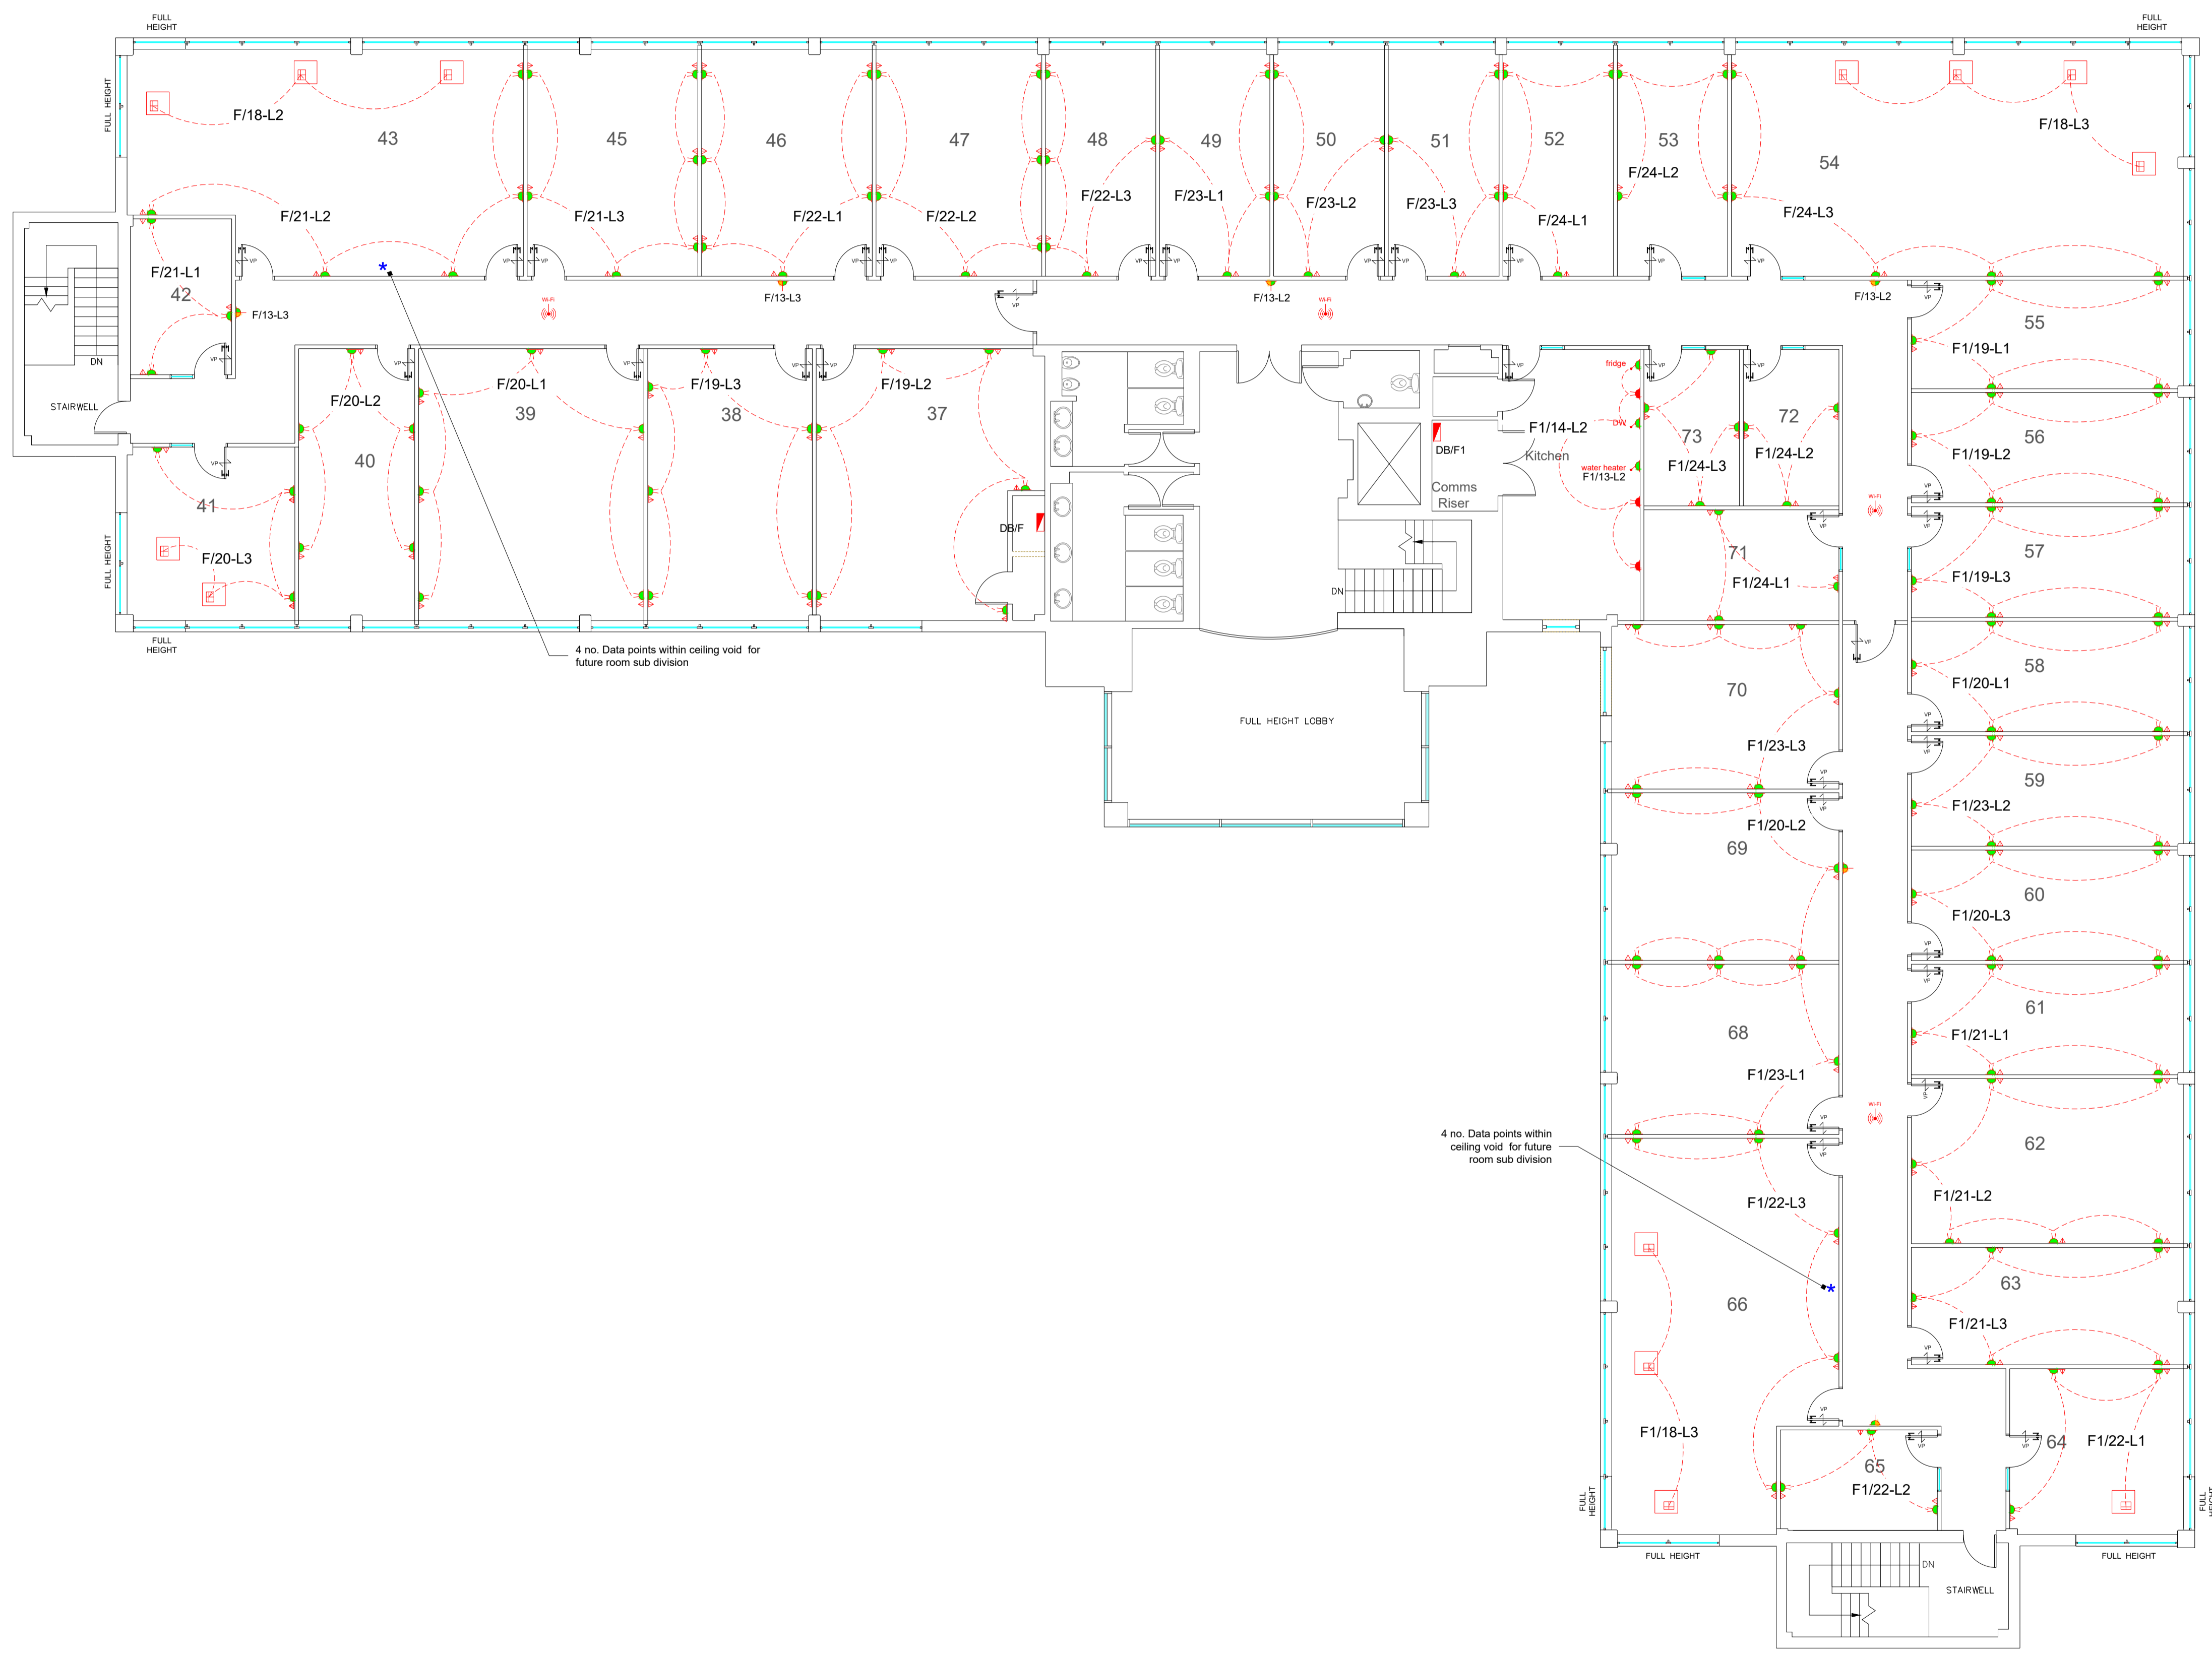

REV	DESCRIPTION	DATE

CLIENT

BIZSPACE

PROJECT
**ZENITH HOUSE
 HIGHLANDS ROAD
 SOLIHULL**



DRAWING TITLE
**SMALL POWER AND DATA
 FIRST FLOOR**

STATUS
AS BUILT

SCALE @ A1. DATE. DRAWN BY.
 1:100 07/06/18 MC

DRAWING NO. Rev
 11350/xx/12-105